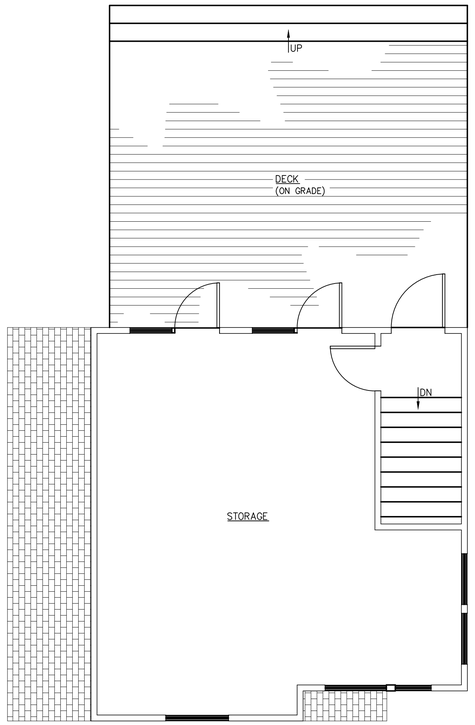

GARAGE SECOND FLOOR PLAN

SCALE: 1/4" = 1'-0"

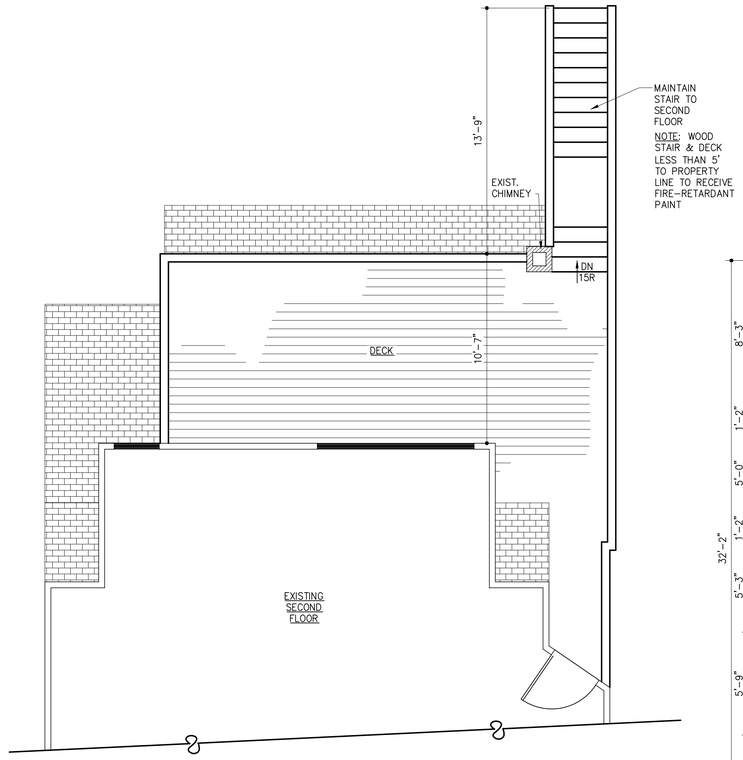

PART SECOND FLOOR PLAN

SCALE: 1/4" = 1'-0"

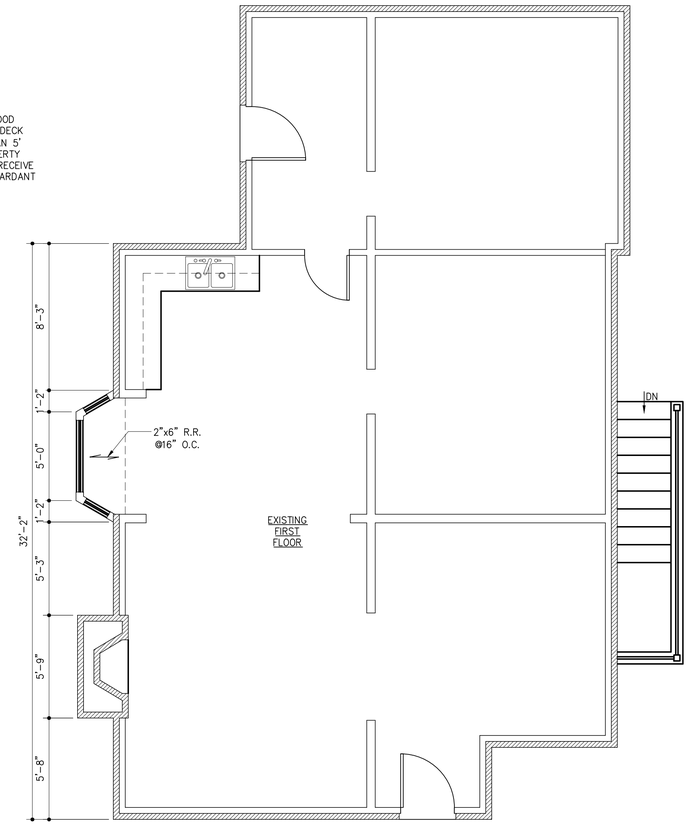

FIRST FLOOR PLAN

SCALE: 1/4" = 1'-0"

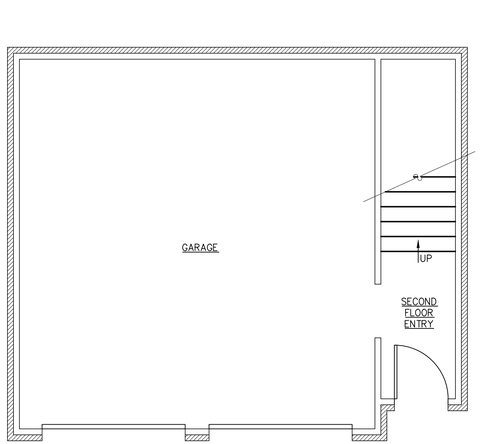

GARAGE PLAN

SCALE: 1/4" = 1'-0'

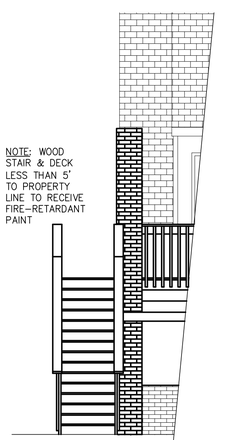

REAR ELEVATION

SCALE: 1/4" = 1'-0"

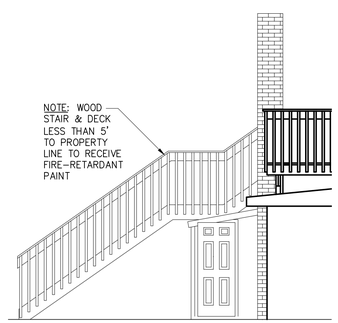

WEST ELEVATION

SCALE: 1/4" = 1'-0"

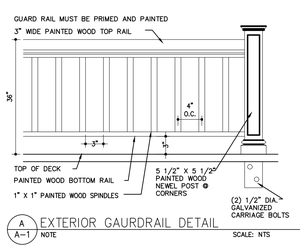

A / A-1 EXTERIOR GAURDRAIL DETAIL NOTE

SCALE: NTS

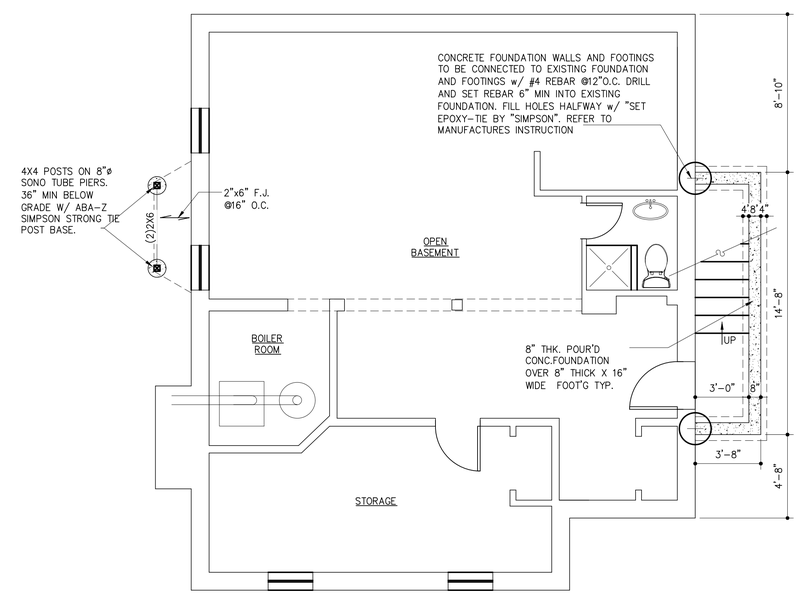

BASEMENT PLAN

SCALE: 1/4" = 1'-0"

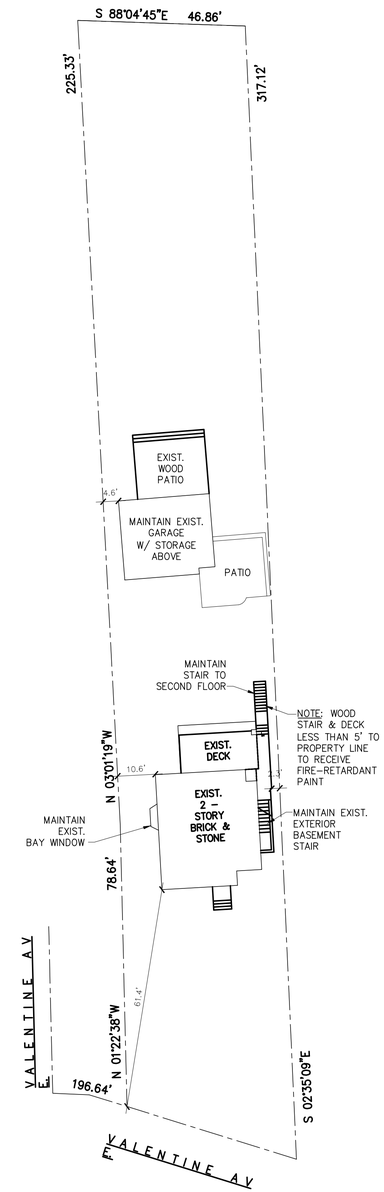

SITE PLAN

SCALE: 1" = 20'-0"

REVISIONS

NR.	DATE	REVISION

JAMES O'GRADY
architects aia

126 Glen Street
Glen Cove, NY 11542
516-801-6311

As-Built / Maintain
For:
53 VALENTINE AVE.
GLEN COVE, NEW YORK

Drawing Title:
SITE PLAN
FLOOR PLANS

Drawing scale:
AS NOTED

Date:
JUNE 24, 2020

Drawing No.
A-1